

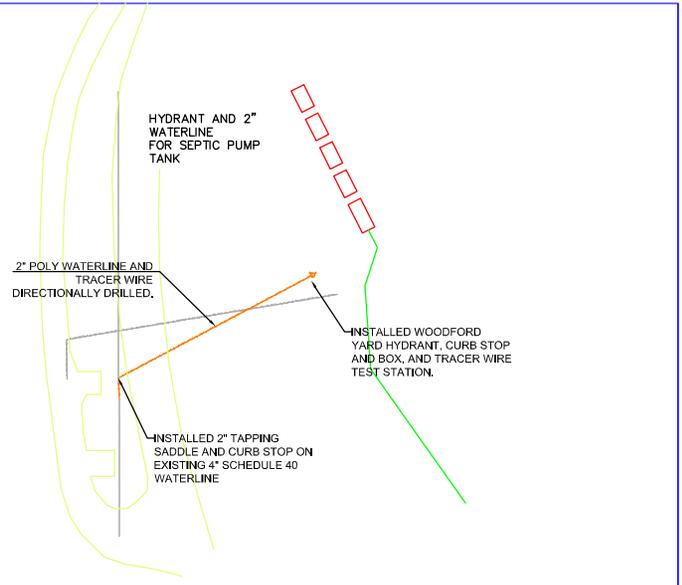


**Shower House F.W. Kent Park
Project # 2250000910**


**ATTACHMENT 4
PHASE 1 RECORD DRAWINGS**

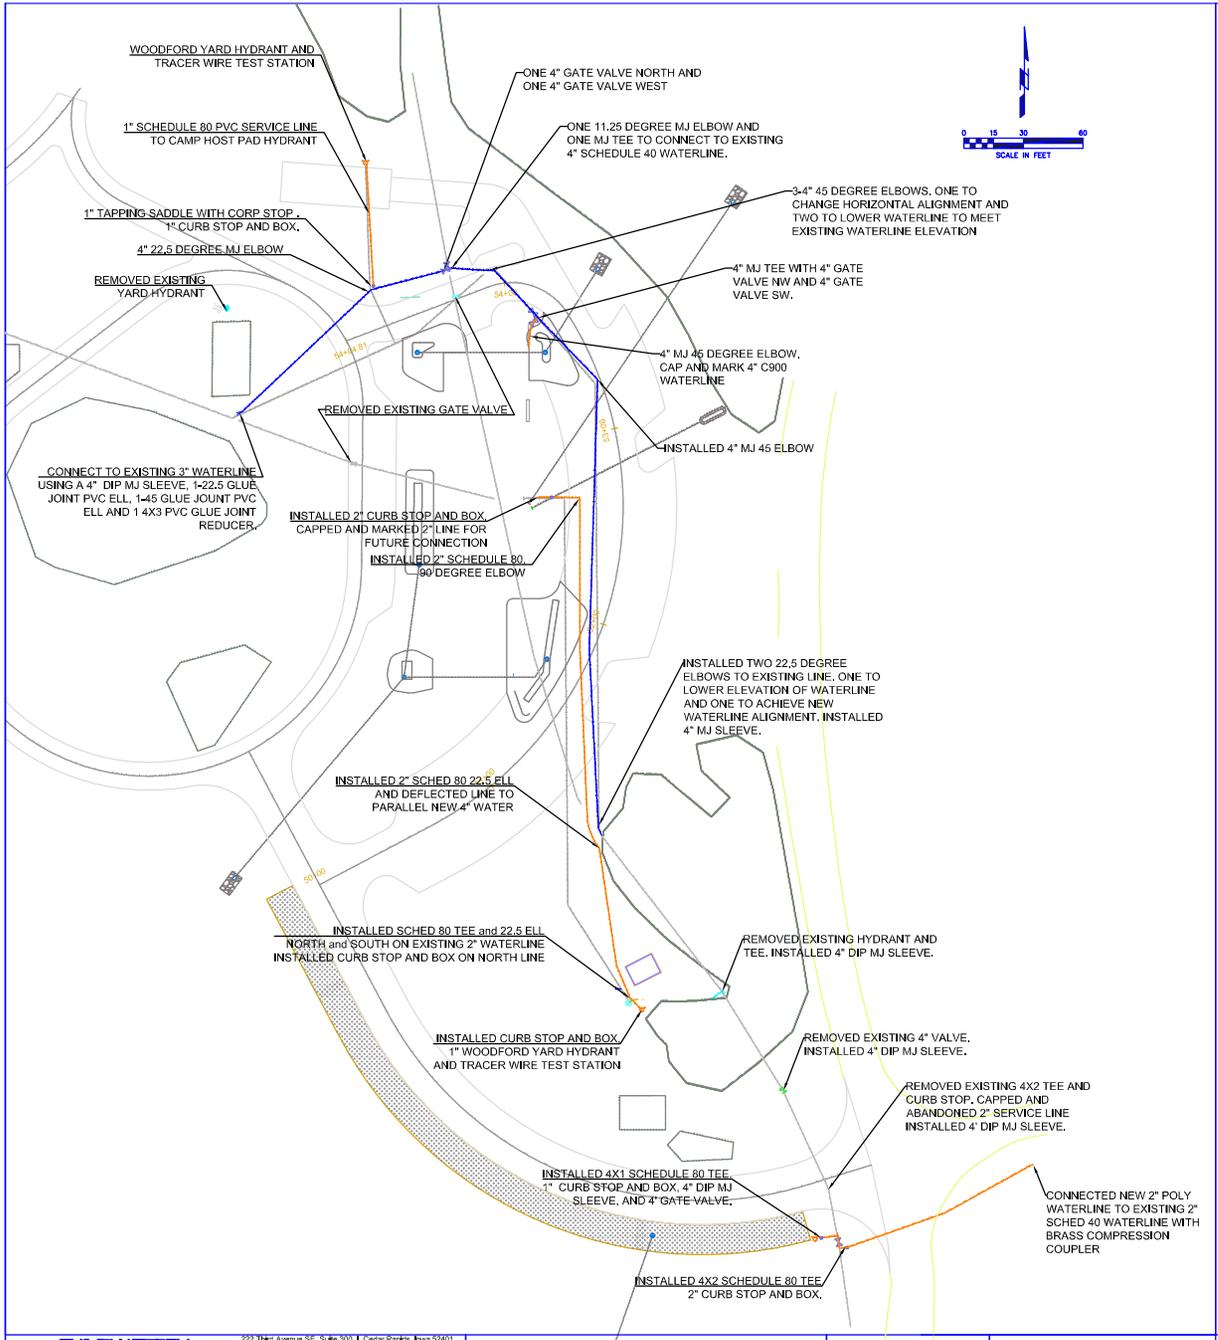

1. ALL MJ FITTINGS CONNECTED WITH MEGALUGS.
2. ALL DIP FITTINGS AND VALVES WRAPPED IN POLYETHYLENE.
3. TRACER WIRE ON ALL NEW WATERLINES.
4. GRANULAR CHLORINE PLACE IN EACH PIPE DURING INSTALL.
5. ALL FITTINGS VISUALLY INSPECTED 24 HOURS AFTER FILLING LINE.

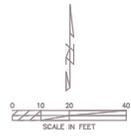


C 4' 0" S
 1" = 40'
 1" = 40'
 1" = 40'

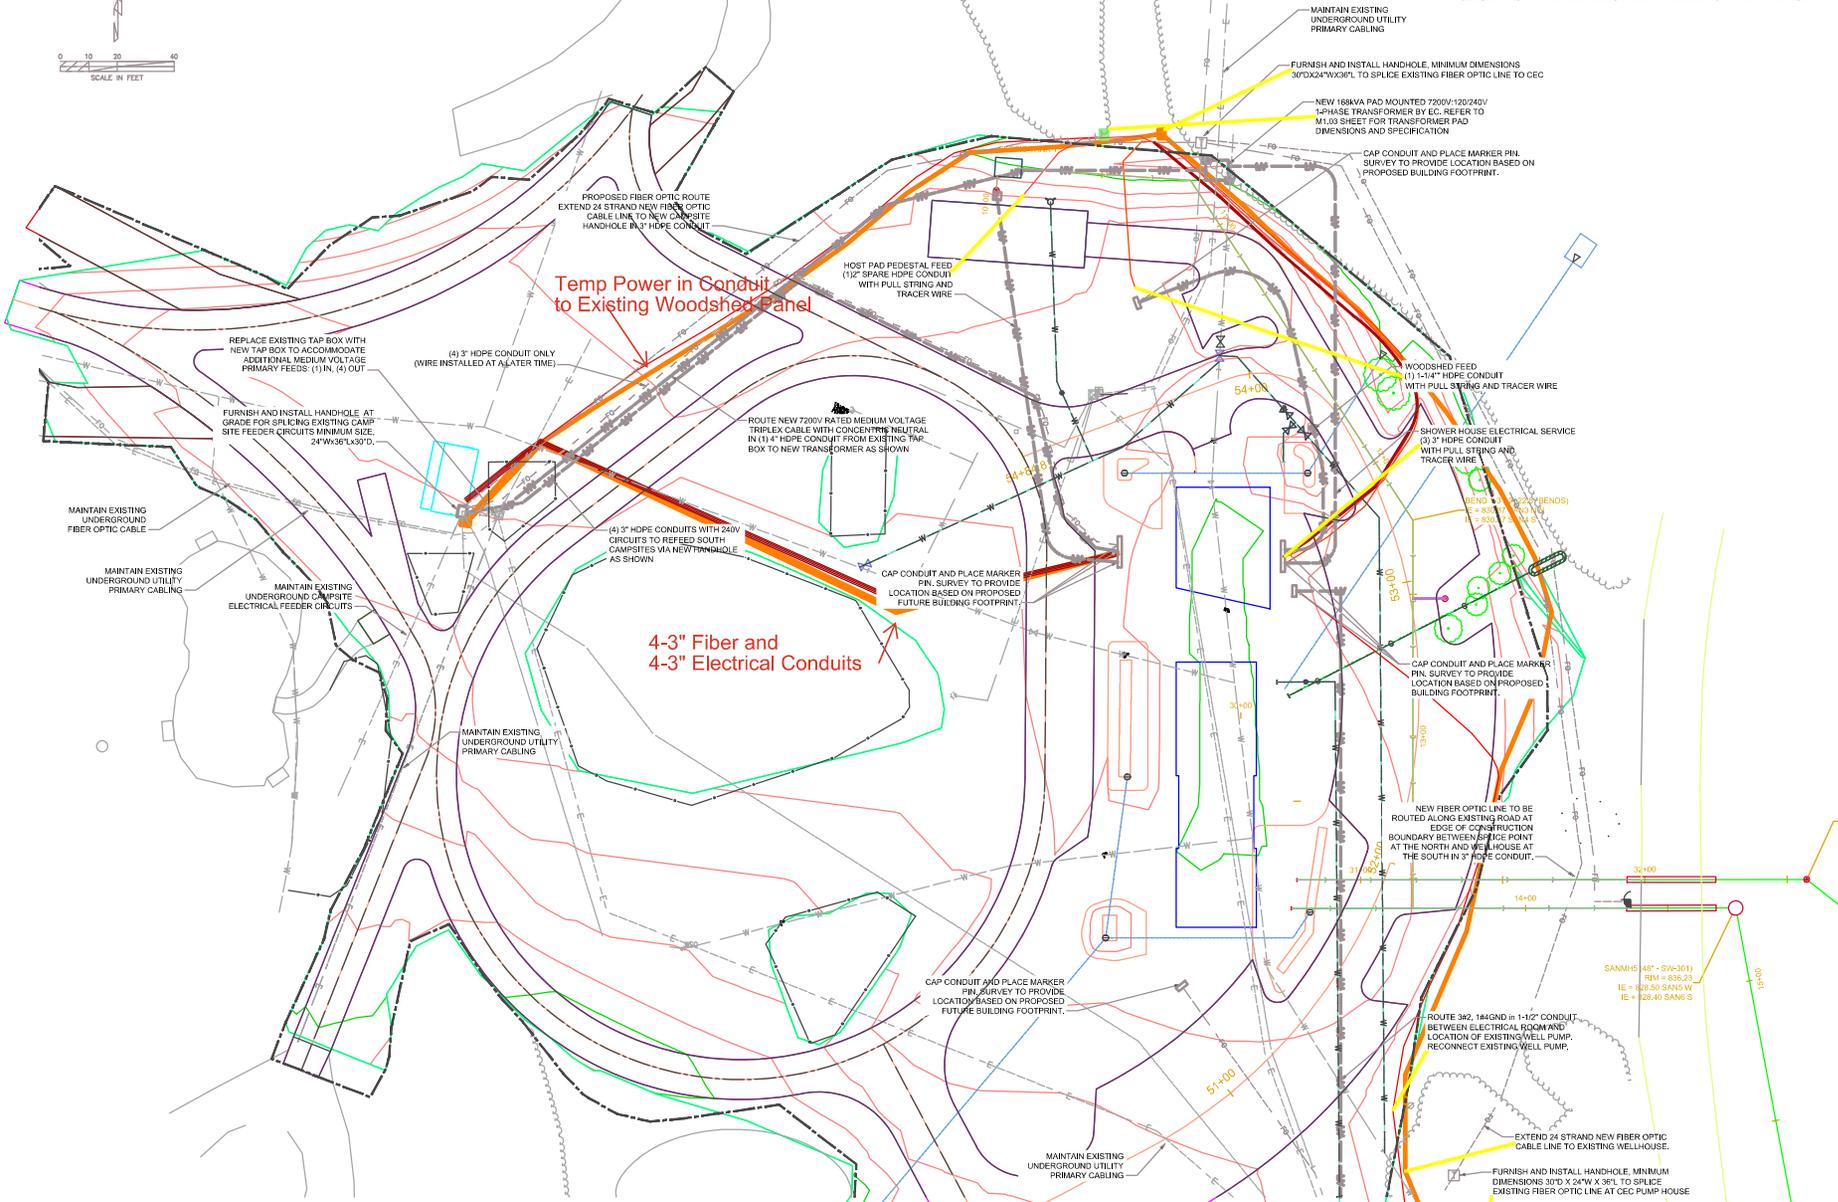



Temp Power in Conduit to Existing Woodshed Panel

4-3" Fiber and 4-3" Electrical Conduits

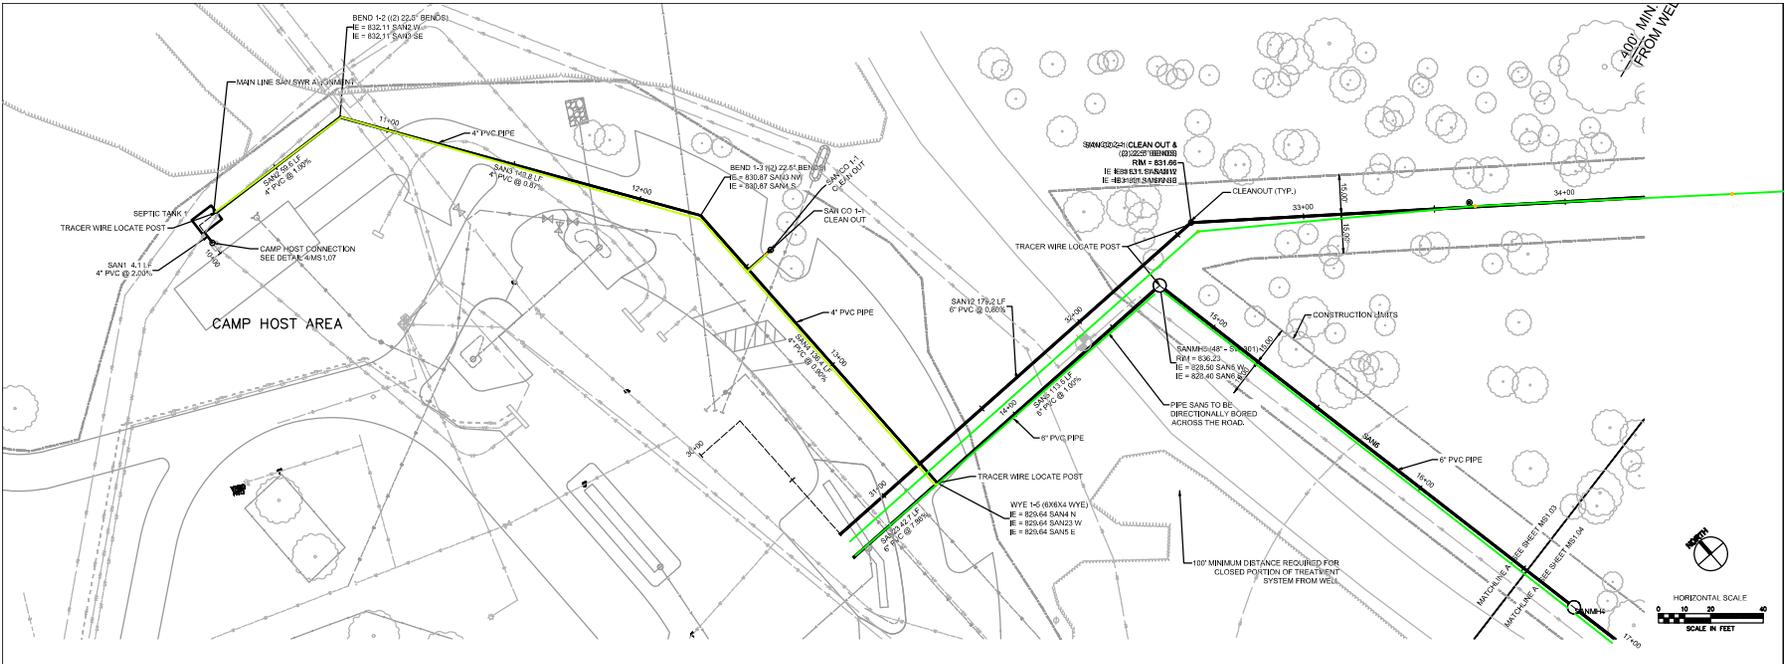


As-Built 2024


GENERAL NOTES:
 1. FROM SEPTIC TANK 1 TO STATION 10+88 CONTRACTOR SHALL PLACE 2 INCH X 45 INCH POLYSTYRENE CENTERED OVER PIPE (APPROXIMATELY 66 LF).
 2. SEPTIC TANK #1 IS 1,250 GALLON CONCRETE TANK WITH POLYLOCK FILTER ON OUTLET PL-122.

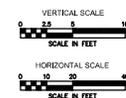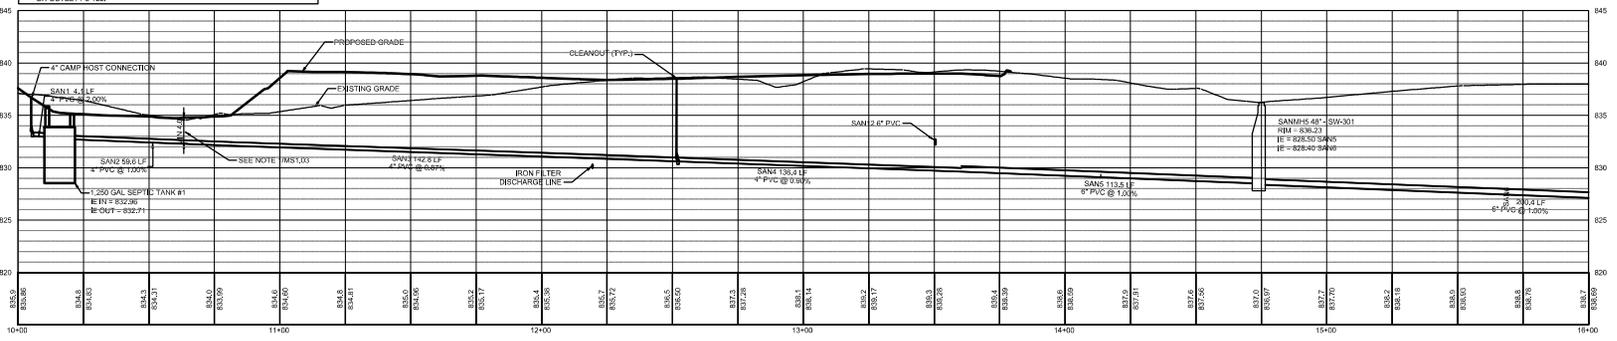


ADDENDUM 01 NOTES 02/14/2024
 -UPDATED LABEL TO ADDRESS ROAD CROSSING

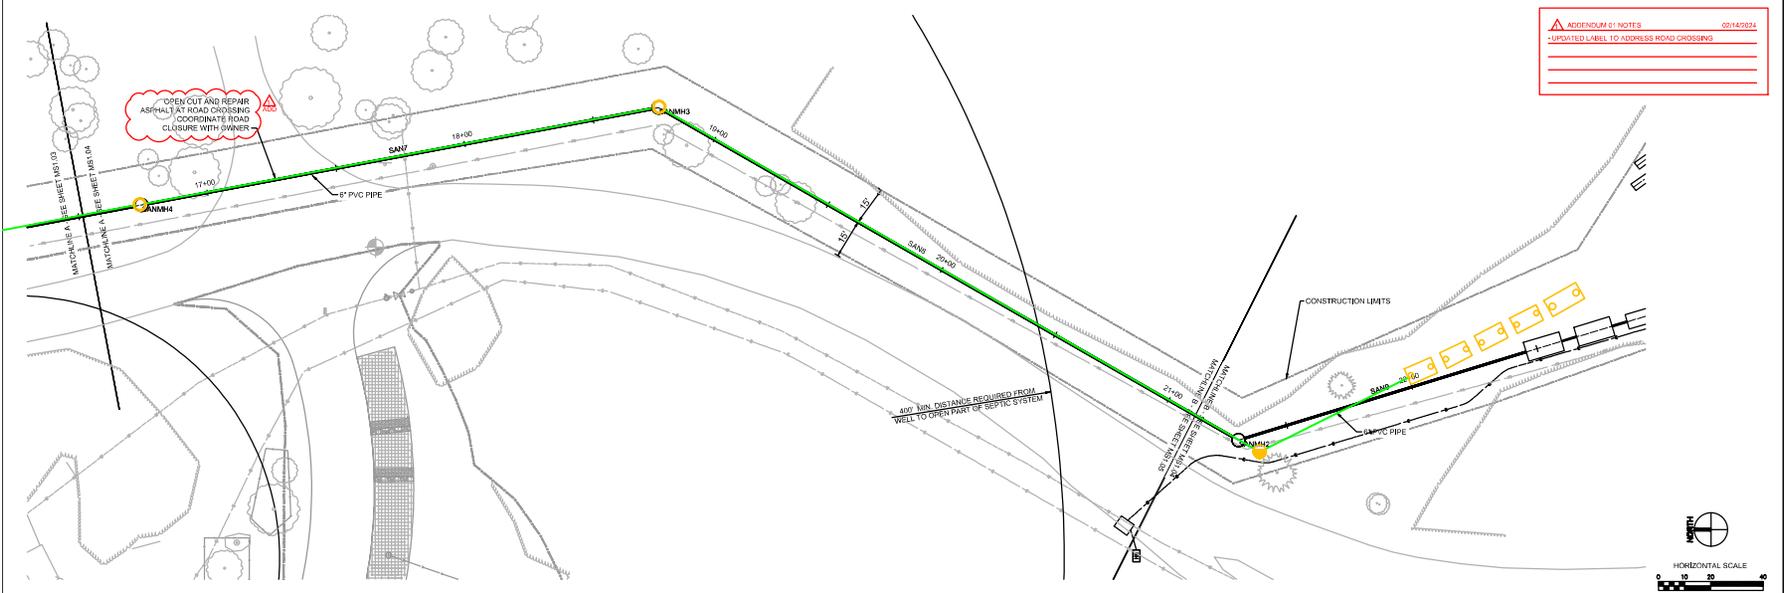



AS-BUILT
 SANITARY SEWER 2024

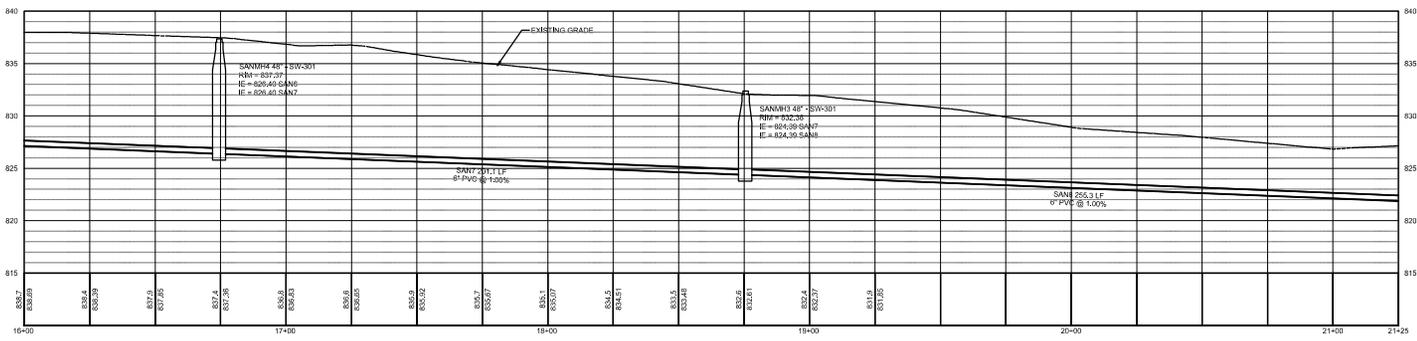

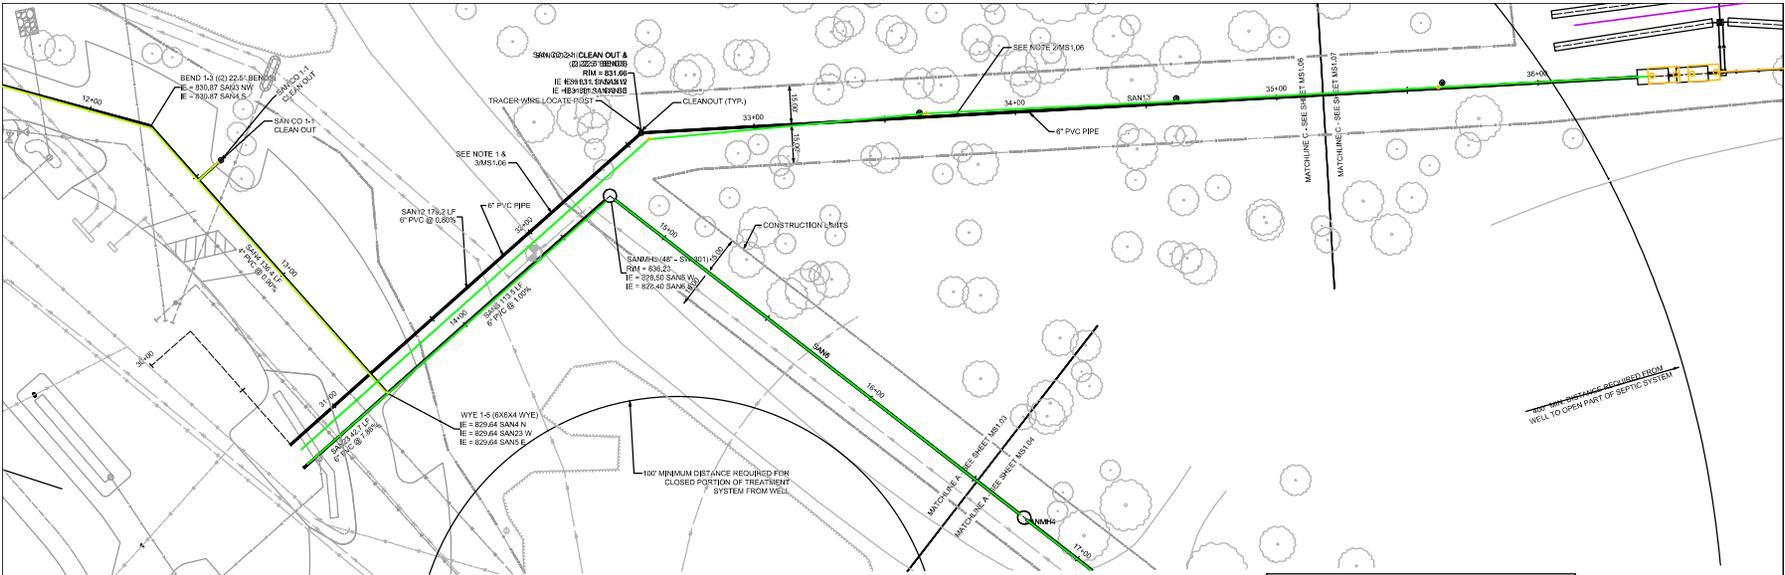



**AS-BUILT
SANITARY SEWER 2024**

- GENERAL NOTES:**
1. FROM STATION 32+00 - 35+00, CONTRACTOR SHALL PLACE 2 INCH X 48 INCH POLYETHYLENE CENTERED OVER PIPE (APPROXIMATELY 30"±).
 2. WHERE THERE IS LESS THAN 4 FEET OF SOIL COVER OVER PIPE, CONTRACTOR TO PLACE FILL ON TOP OF EXISTING GROUND OVER TOP OF PIPE TO BRING COVER TO 4 FOOT MINIMUM. CONTRACTOR TO FEATHER SOIL DOWN FROM CENTER OF PIPE TO TREE LINE ON EACH SIDE. REFER TO SHEETS FOR GRADING DETAILS. GRADING NOTES ON SHEET A1.01 APPLIES. AREA FROM APPROXIMATELY STATION 32+00 - 35+00 IS ANTICIPATED TO NEED FILL TO MEET MINIMUM COVER REQUIREMENT.
 3. CONTRACTOR TO REMOVE AND REPLACE APPROXIMATELY 25 SY OF ASPHALT PARK ROAD AND SUBBASE TO RETAIL PIPE SAN 12. MATCH EXISTING SUBBASE AND PAVEMENT SECTIONS. CONTRACTOR TO PROVIDE OWNER MINIMUM BUSINESS DAYS NOTICE PRIOR TO CLOSING THE PARK ROAD FOR PIPE SAN 12 INSTALLATION. CONTRACTOR TO COORDINATE WITH OWNER ON CLOSURE OF THE ROAD AND LENGTH OF CLOSURE PRIOR TO CONSTRUCTION.

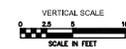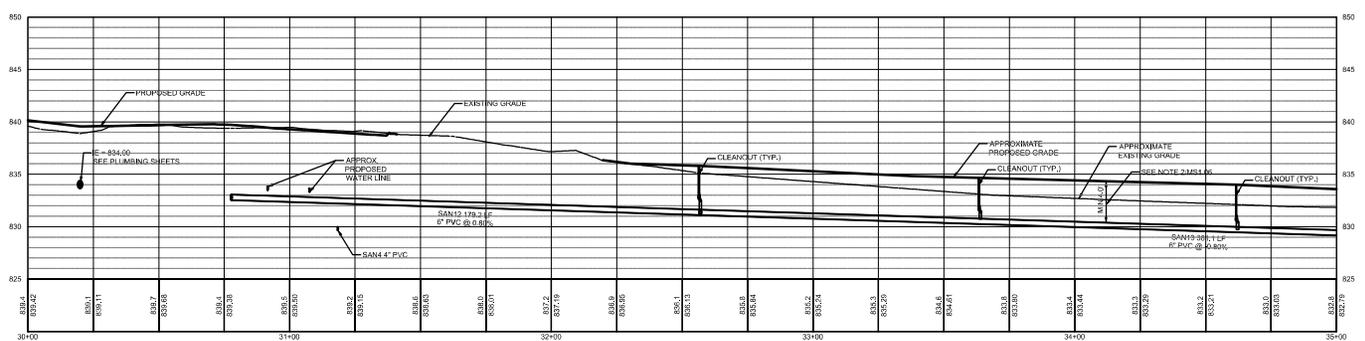





As-Built Leach Field 2024

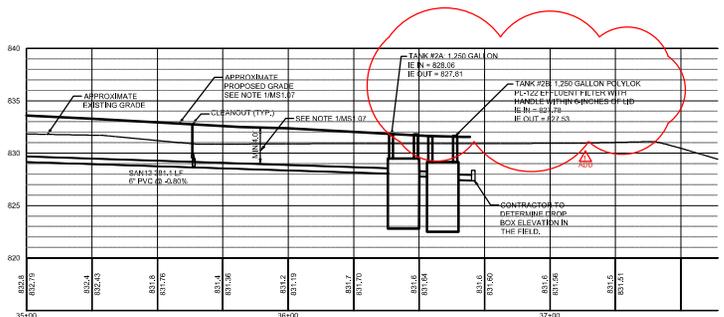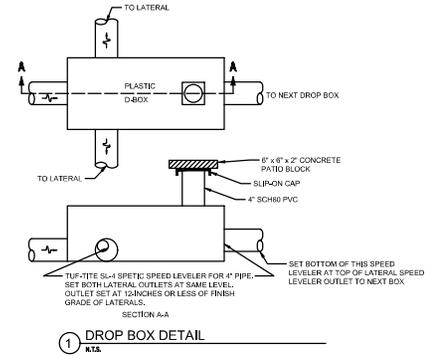

- GENERAL NOTES:**
- WHERE THERE IS LESS THAN 4 FEET OF SOIL COVER OVER PIPE, CONTRACTOR TO PLACE FILL ON TOP OF EXISTING GROUND OVER TOP OF PIPE TO BRING COVER TO 4 FOOT MINIMUM. CONTRACTOR TO FEATHER SOIL DOWN FROM CENTER OF PIPE TO TREE LINE ON EACH SIDE. REFER TO SHEETS FOR GRADING DETAILS. GRADING NOTES ON SHEET A1.01 APPLIES. AREA FROM APPROXIMATELY STATION 34+50 - 36+50 IS ANTICIPATED TO NEED FILL TO MEET MINIMUM COVER REQUIREMENT.
 - TANKS #3 AND #4 SHALL BE 1250 GALLON PLASTIC TANK AND SHALL BE BOTH INFILTRATOR OR COON TANK. BENCH L, WITH CRUSHED ROCK OR CRUSHED CONCRETE MINIMUM 24\"/>

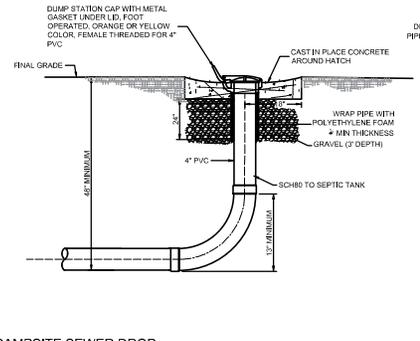







4 CAMPSITE SEWER DROP
NOT TO SCALE

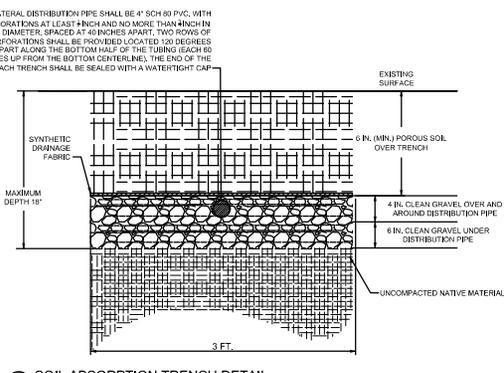





3 SOIL ABSORPTION TRENCH DETAIL
NOT TO SCALE

ADDENDUM 01 NOTES 02/14/2024
 CHANGED PROFILE LABELS TO MATCH PLAN LABELS

As-Built 2024

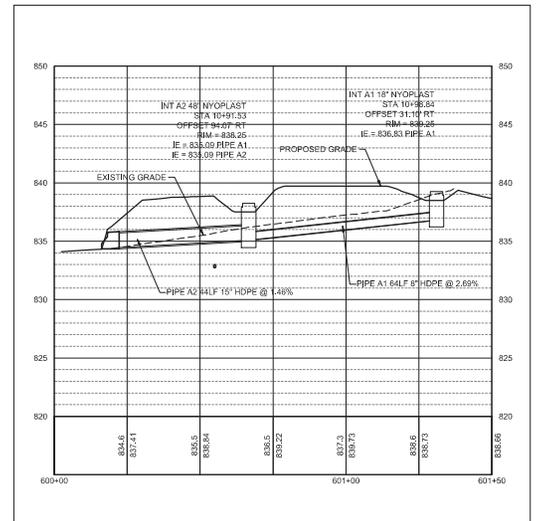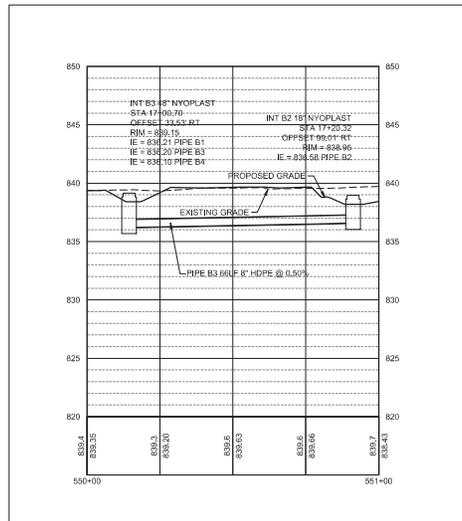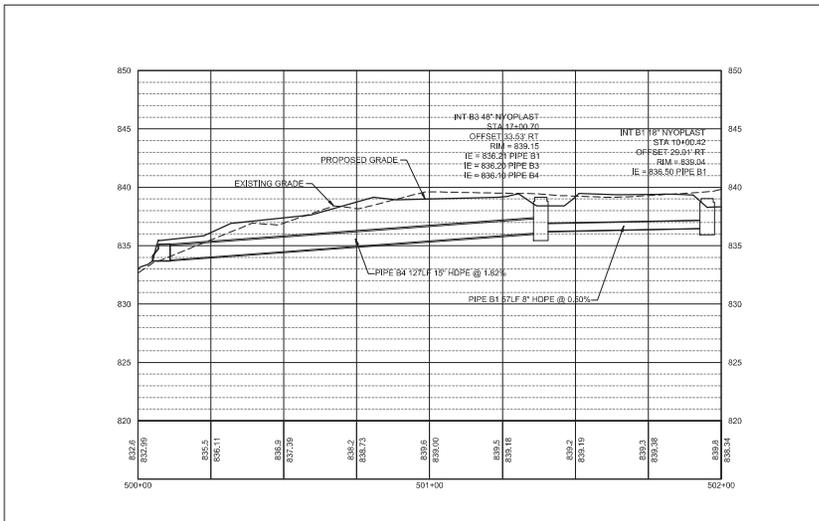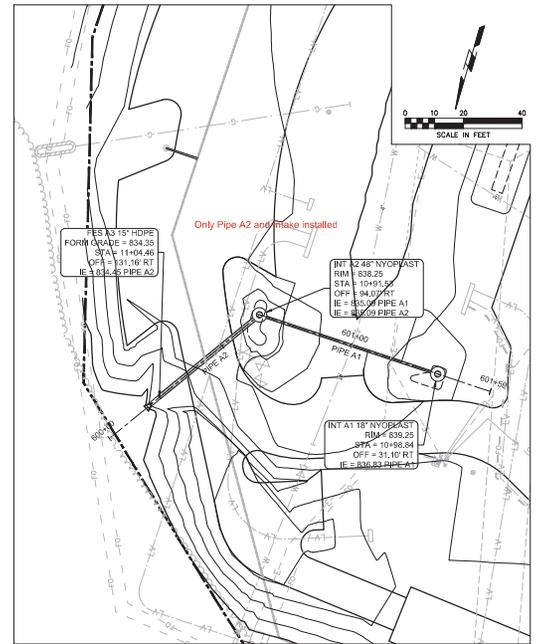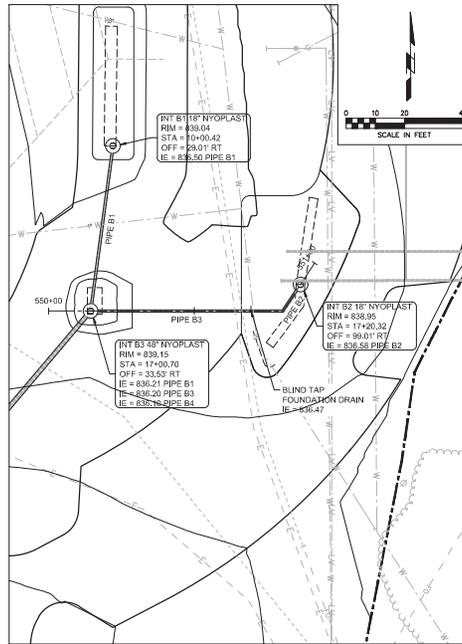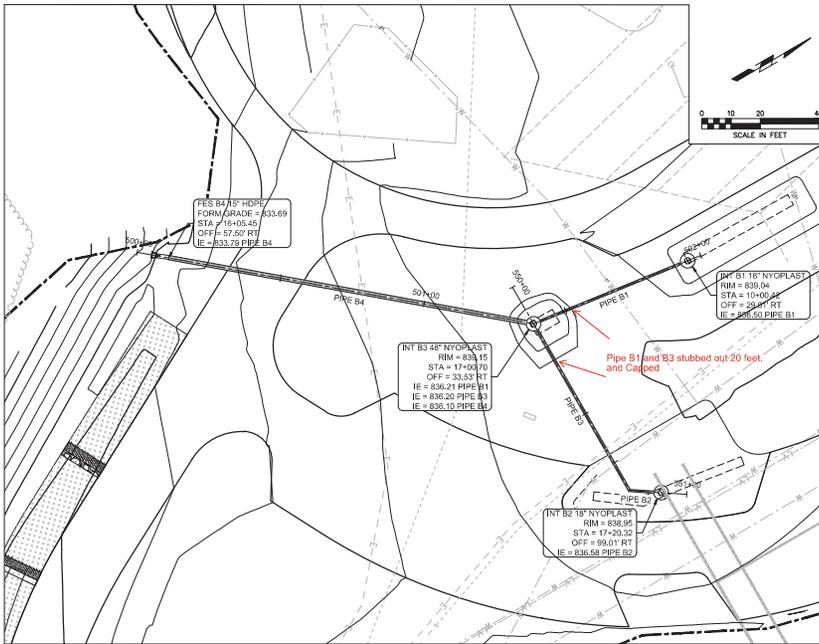

NOTE: SEE U-SHEETS FOR INTAKE DETAILS

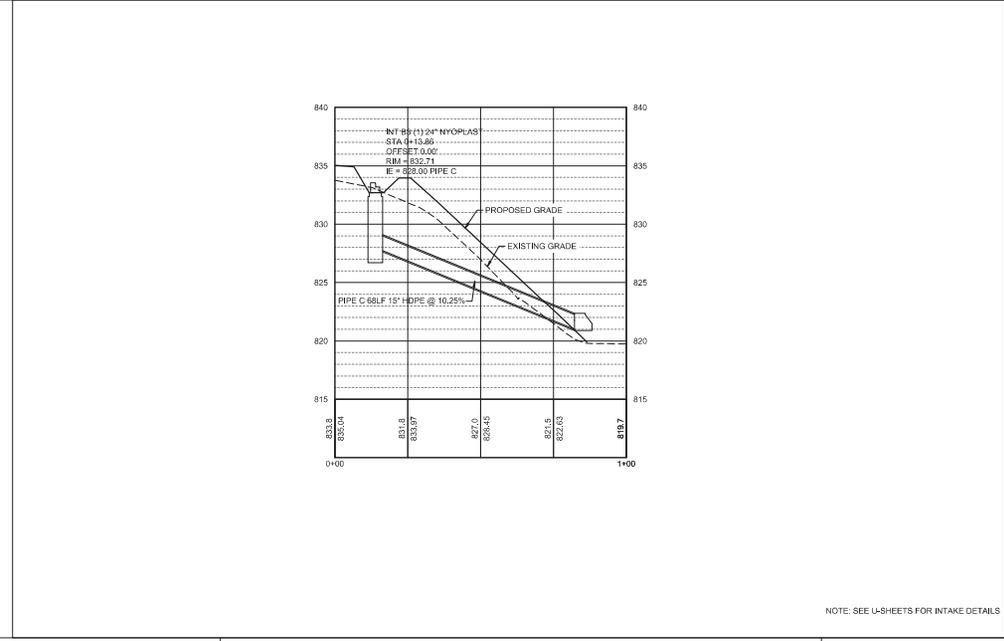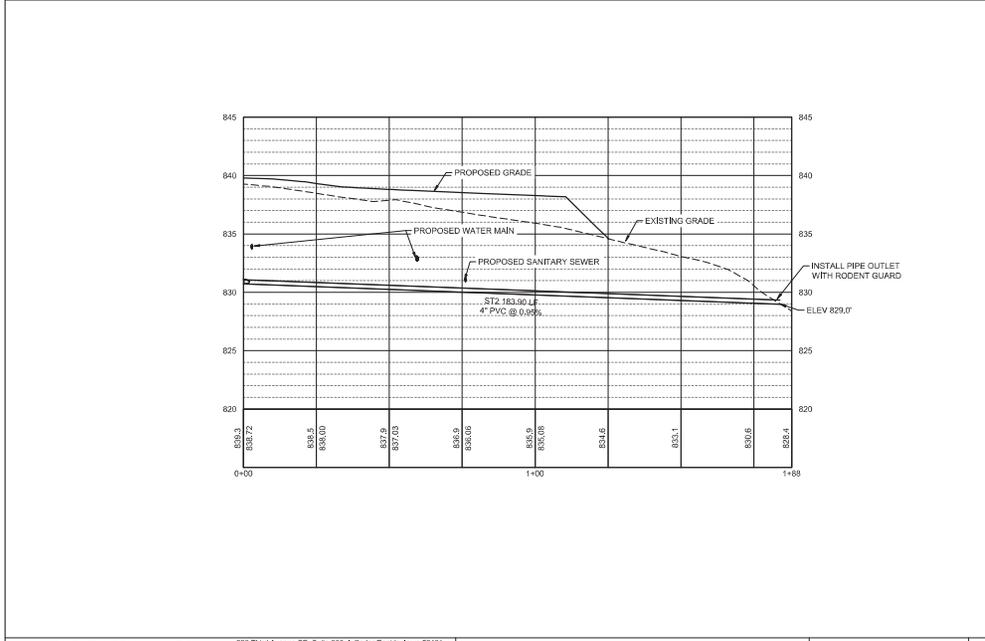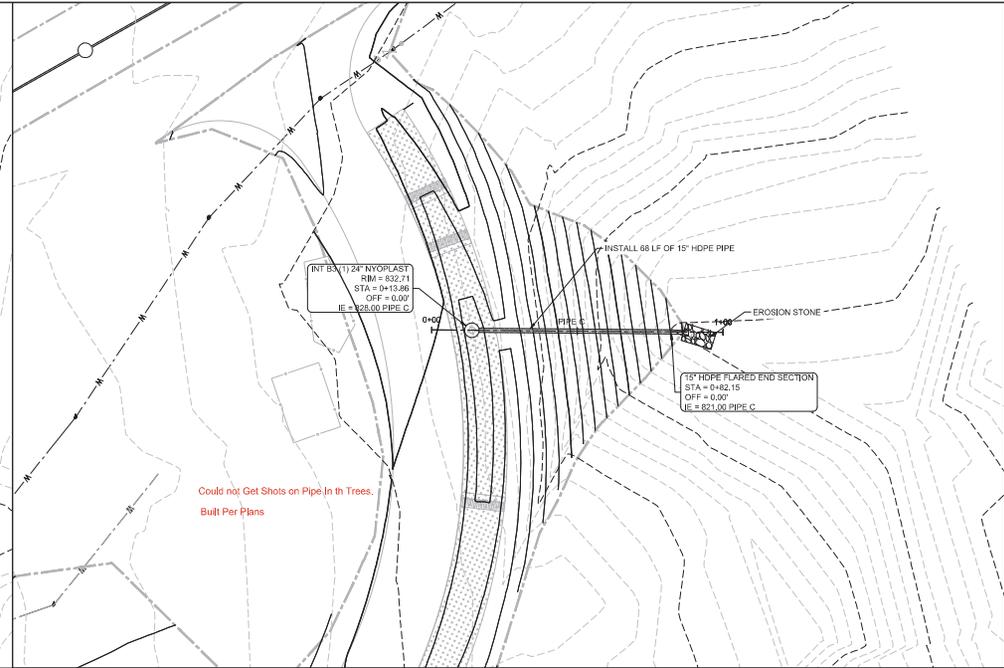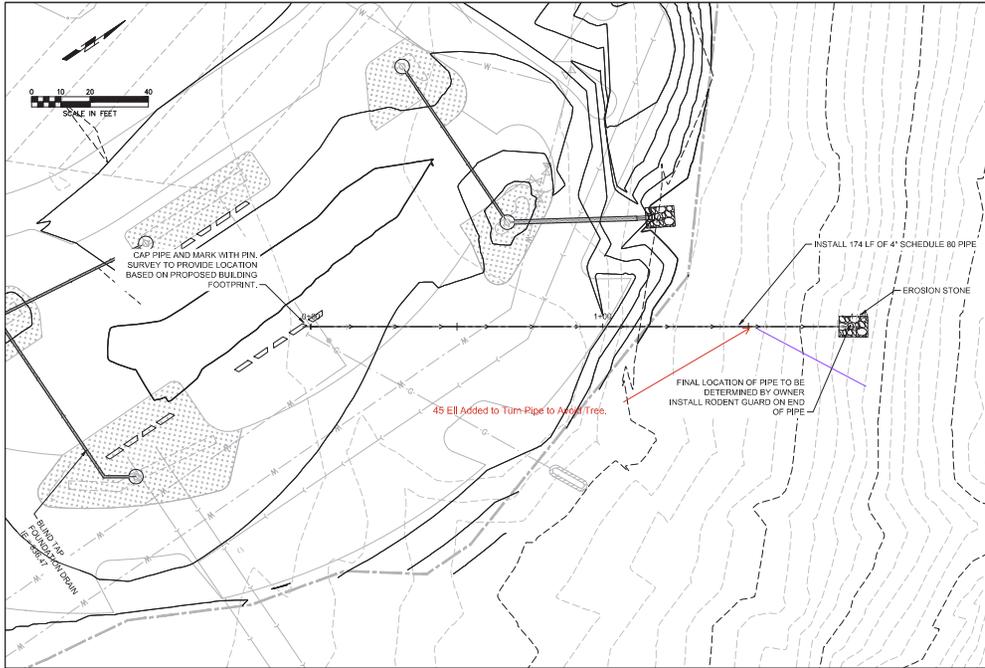

NOTE: SEE U-SHEETS FOR INTAKE DETAILS